
## SUITE: 1260


## AS-BUILT CONFIGURATION

RECEPTION	1
OFFICES	3
CONFERENCE ROOMS	1
KITCHEN / BREAKOUT	1
OPEN WORK AREA+/	- 28

Not to scale, furniture and appliances not included

## KEY PLAN

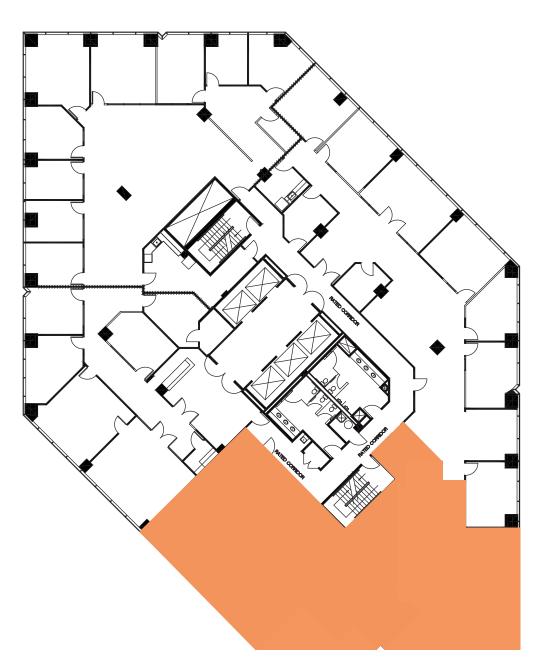

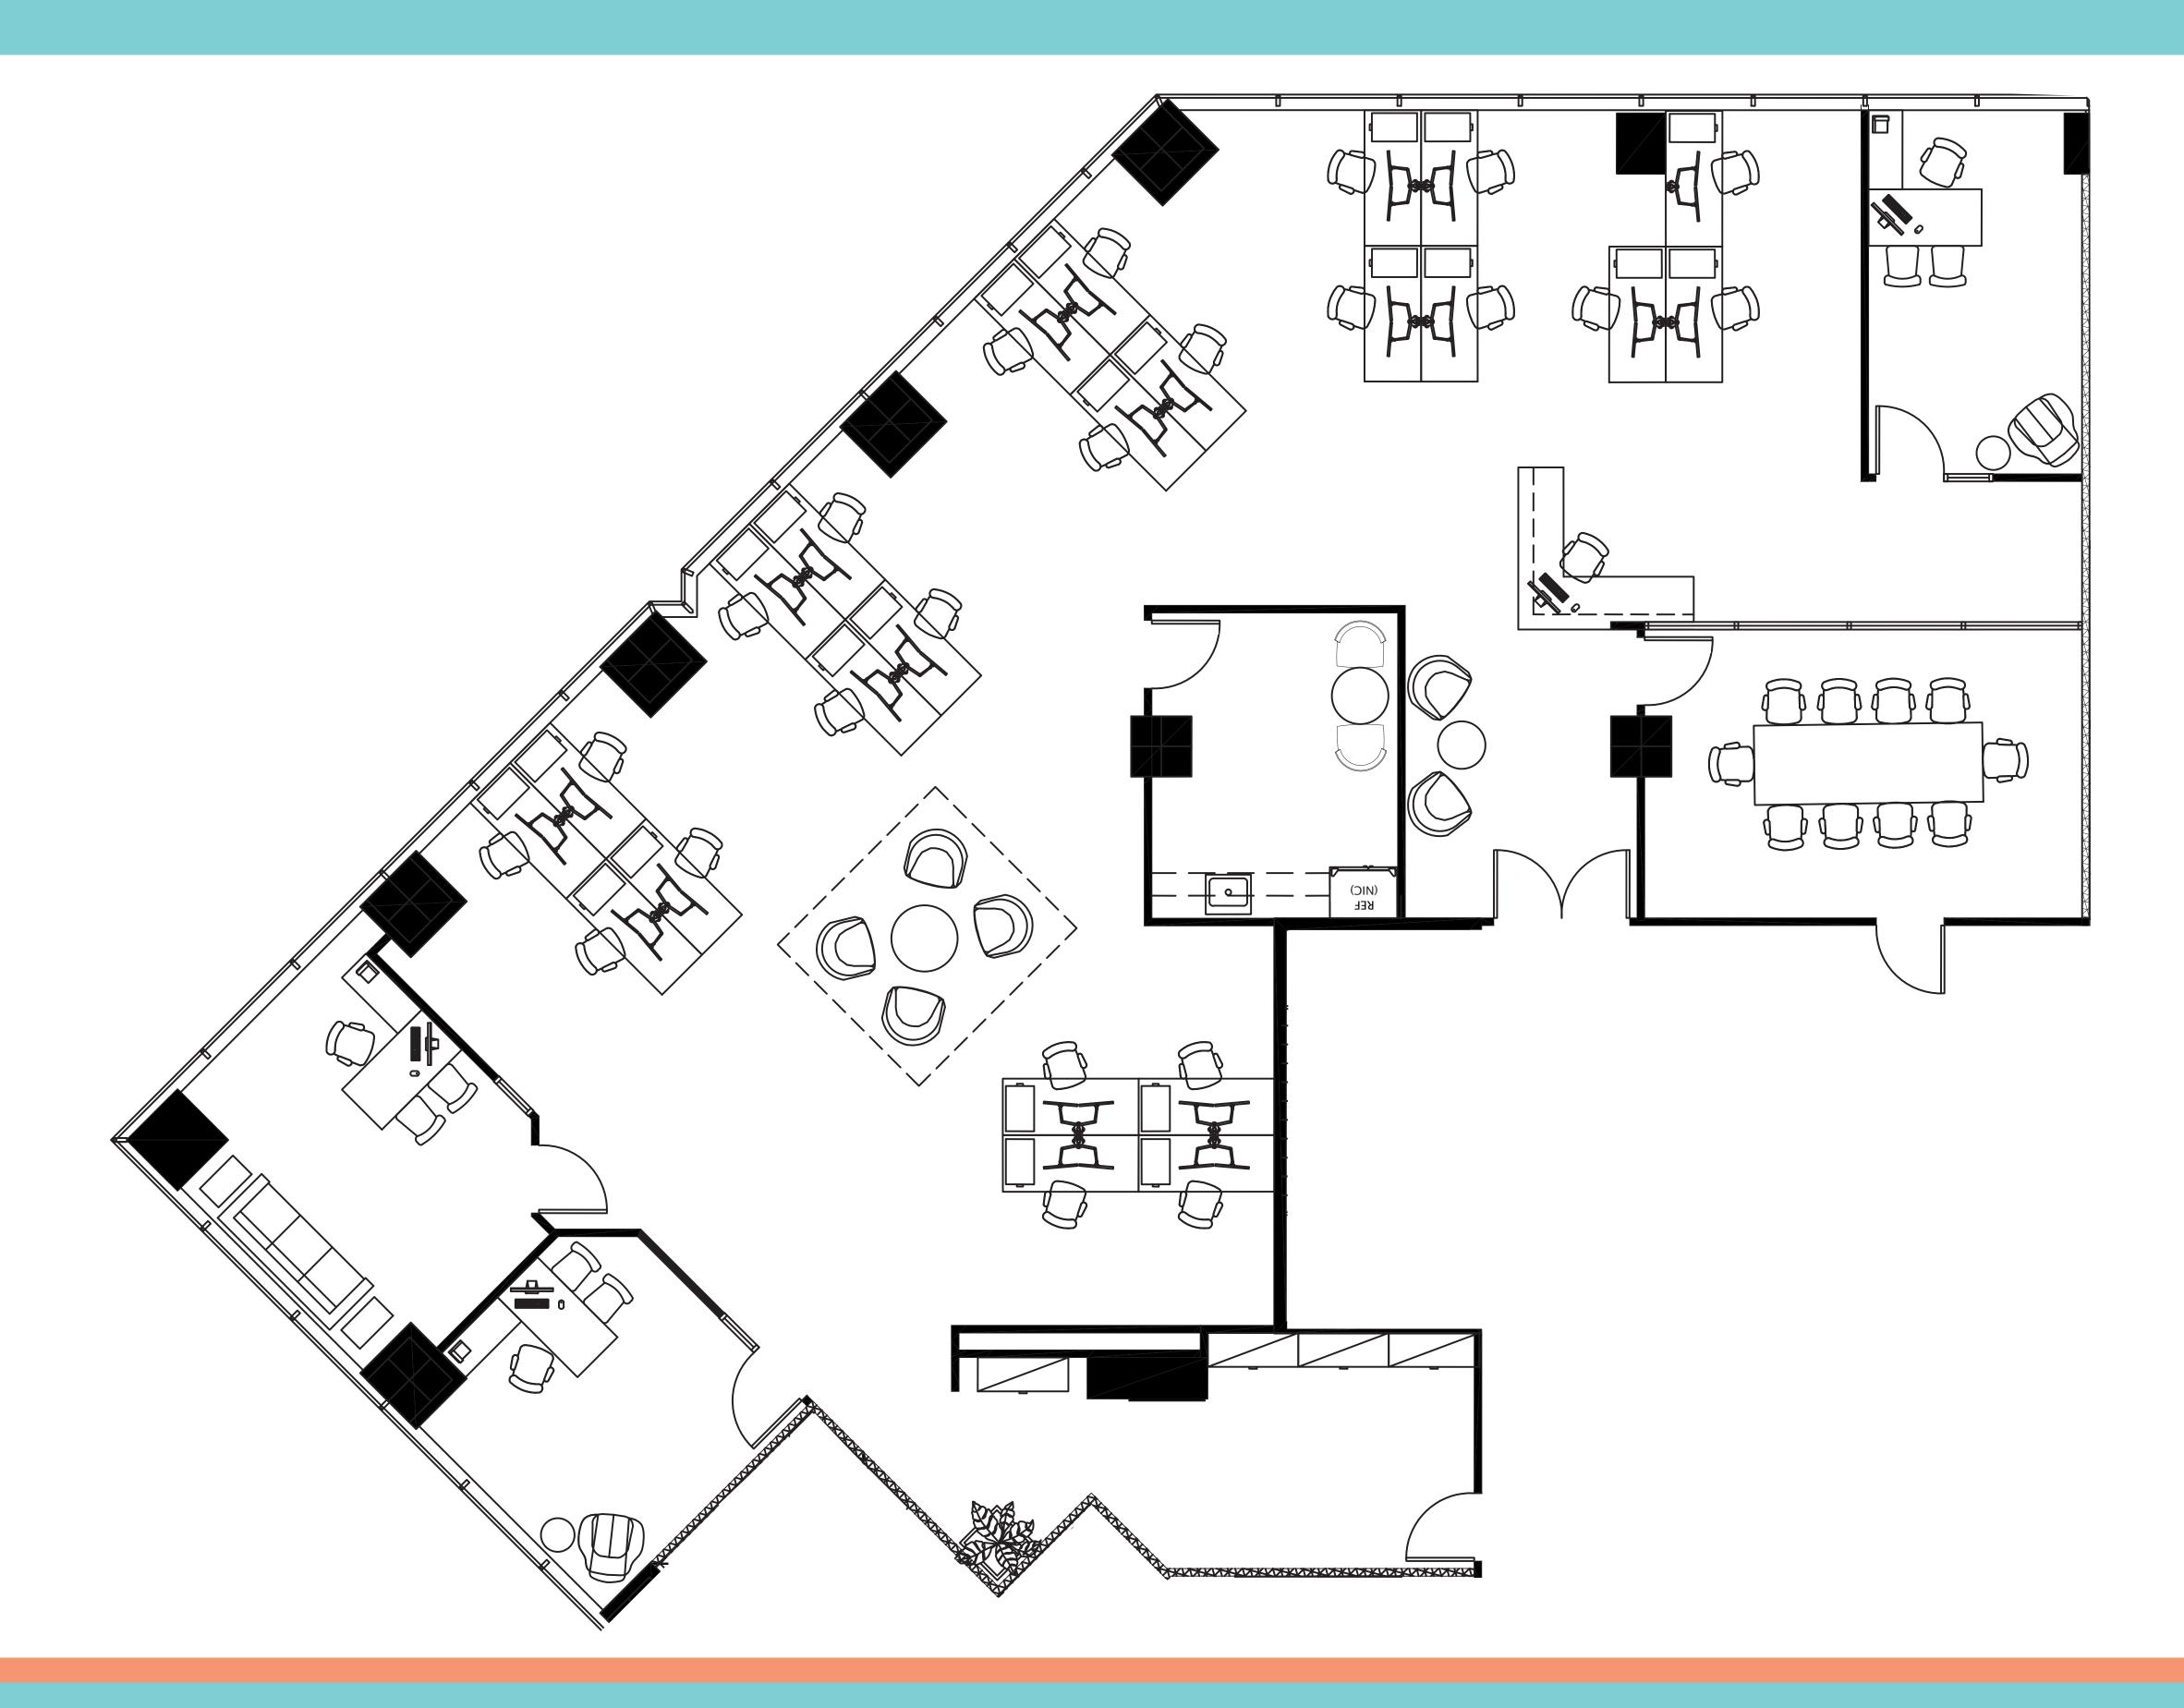

RSF:4,051



