

SUITE: 350

RSF: 4,542



OCEAN
PLAZA

AS-BUILT CONFIGURATION

OFFICES.....	N/A
RECEPTION.....	N/A
CONFERENCE ROOMS.....	N/A
KITCHEN.....	N/A
OPEN WORK AREA.....	N/A

Not to scale, furniture and appliances not included

KEY PLAN

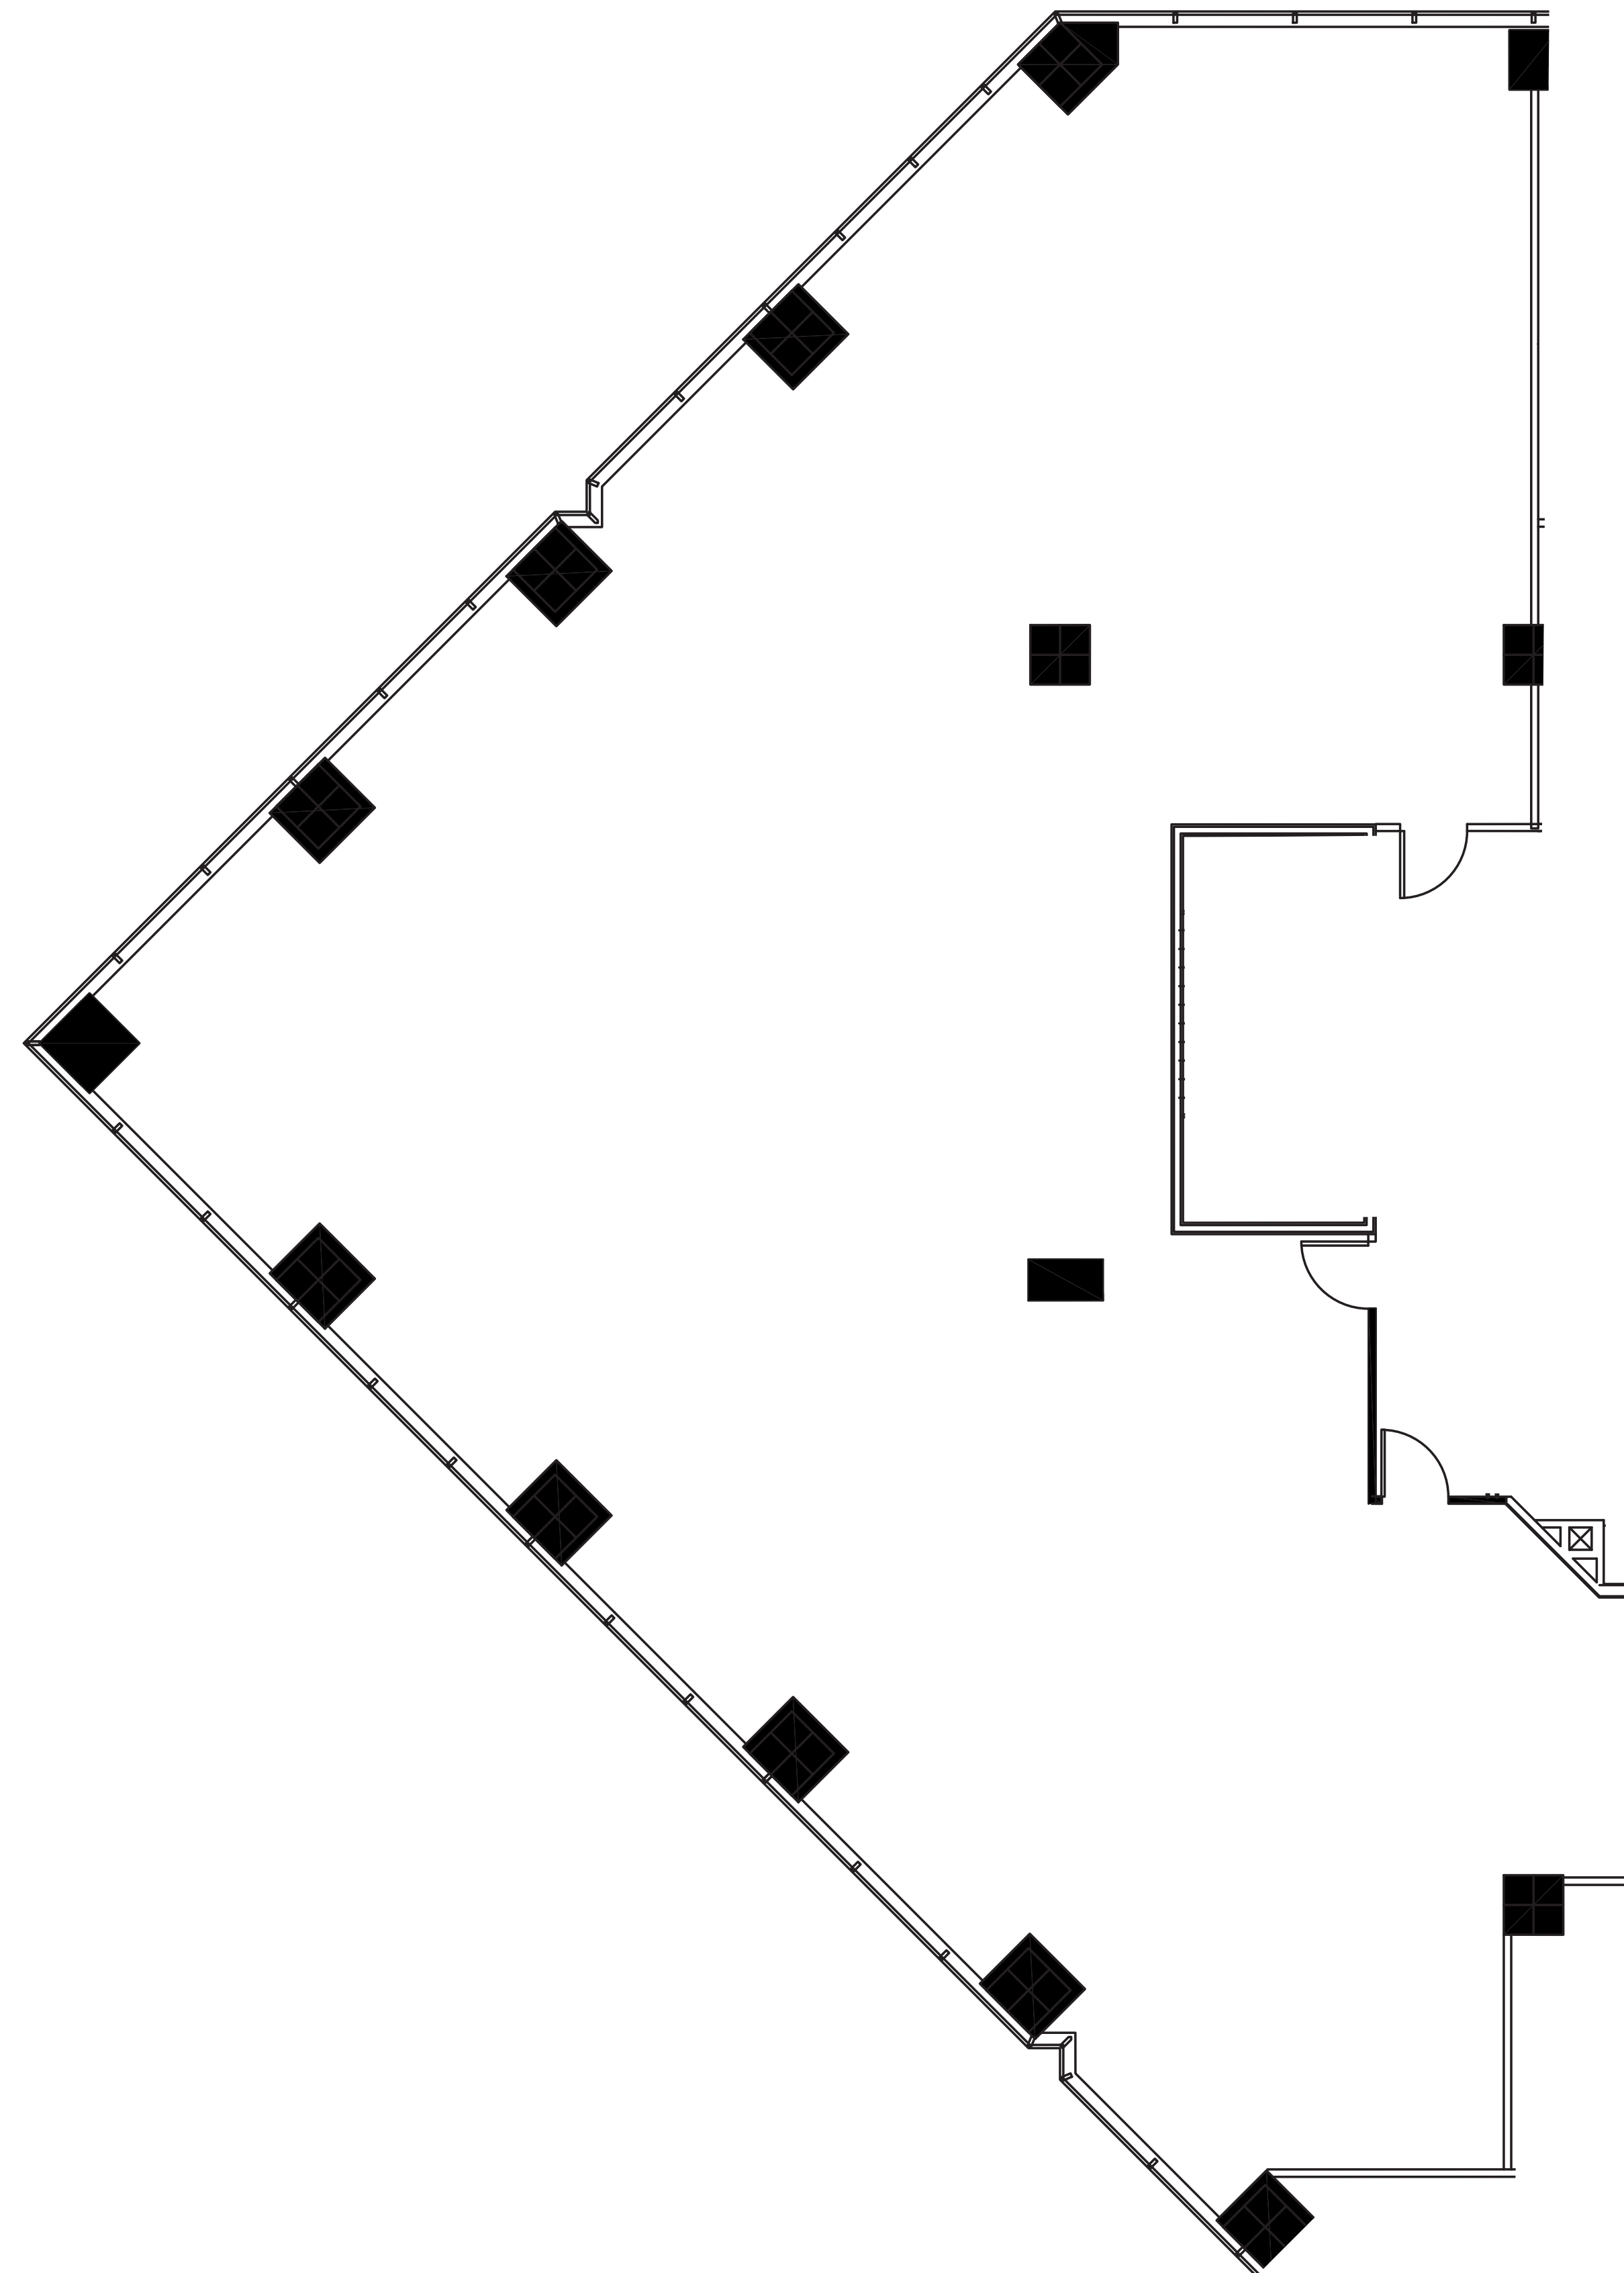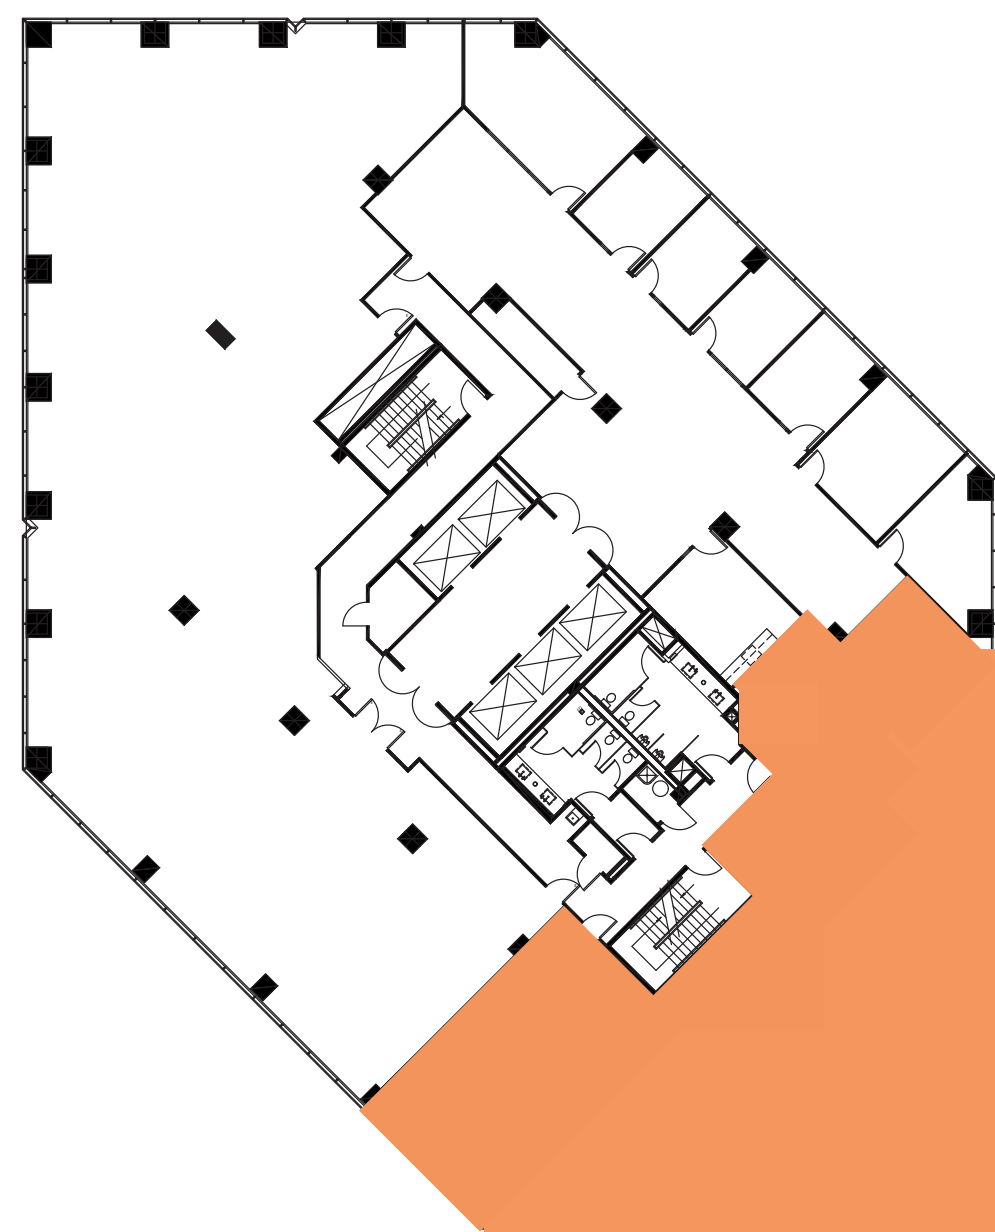

For leasing information please contact:
Jason Ward
949.955.7640 | jason.ward@cushwake.com

Adie Jessup
949.930.9258 | adie.jessup@cushwake.com

John Harty
949.372.4910 | john.harty@cushwake.com

