
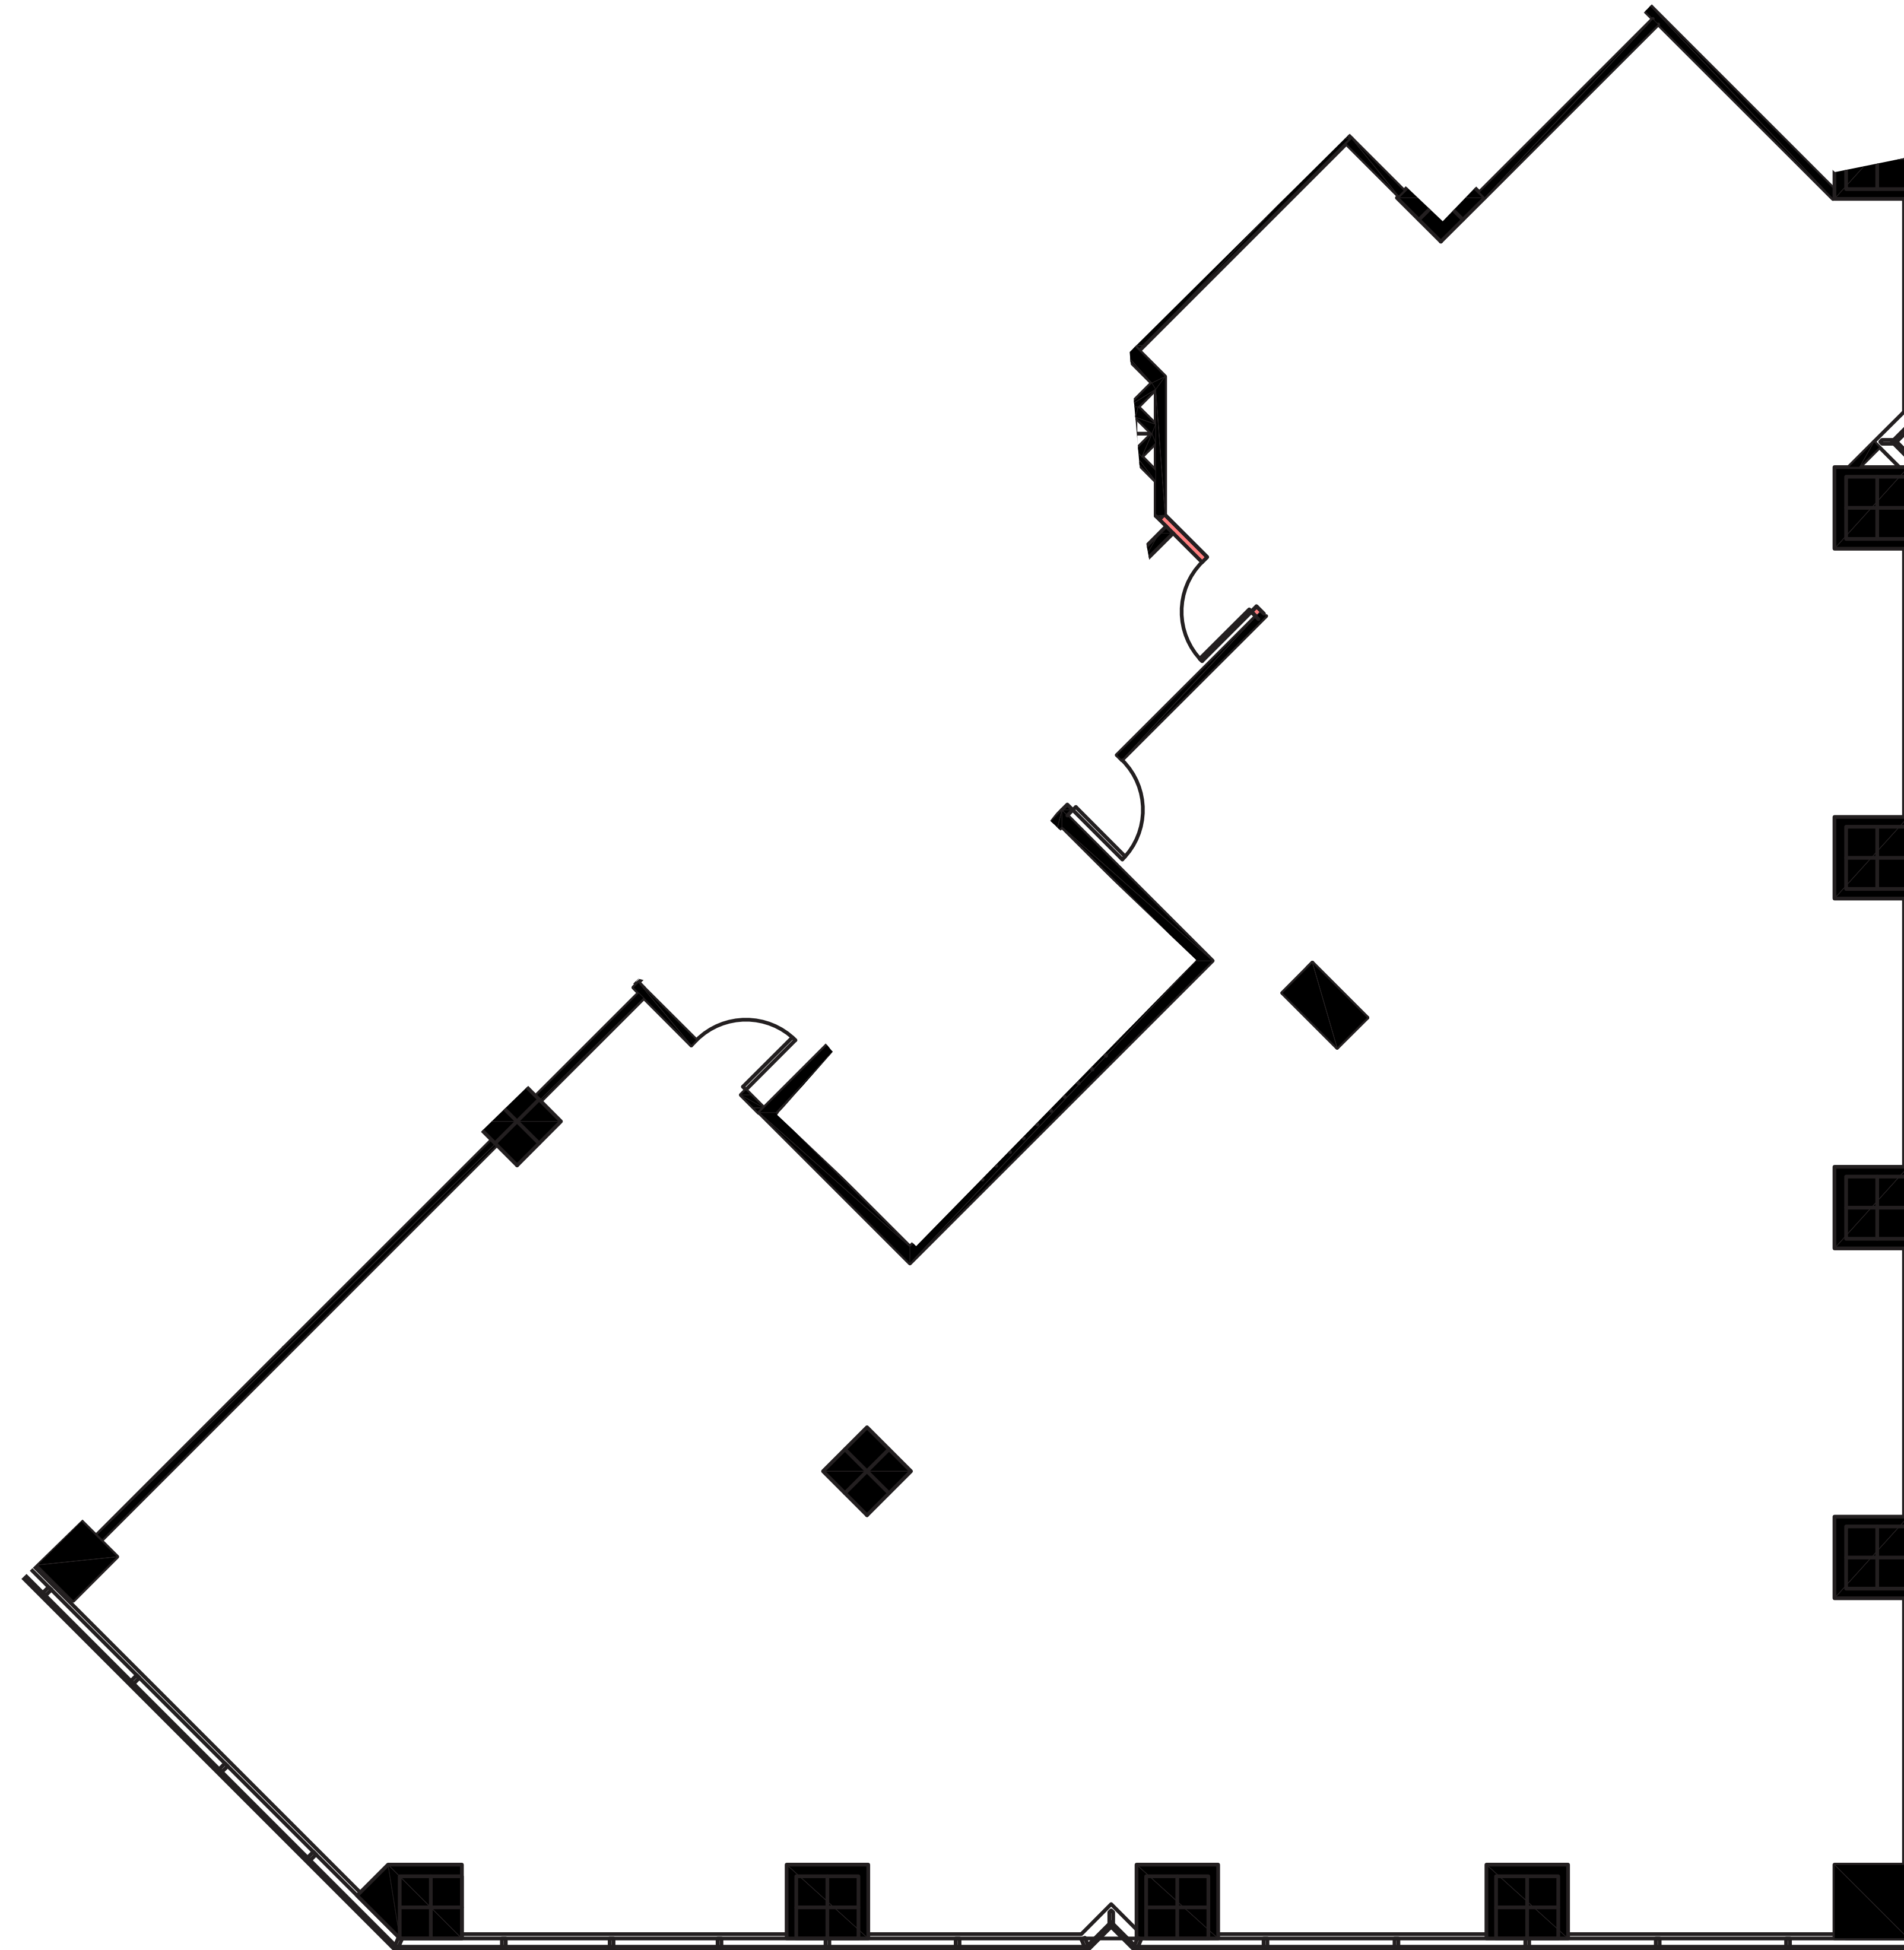


AS-BUILT CONFIGURATION

OFFICES.....	TBD
RECEPTION.....	TBD
CONFERENCE ROOMS.....	TBD
KITCHEN.....	TBD
OPEN WORK AREA.....	TBD

*Not to scale, furniture and appliances not included*

KEY PLAN

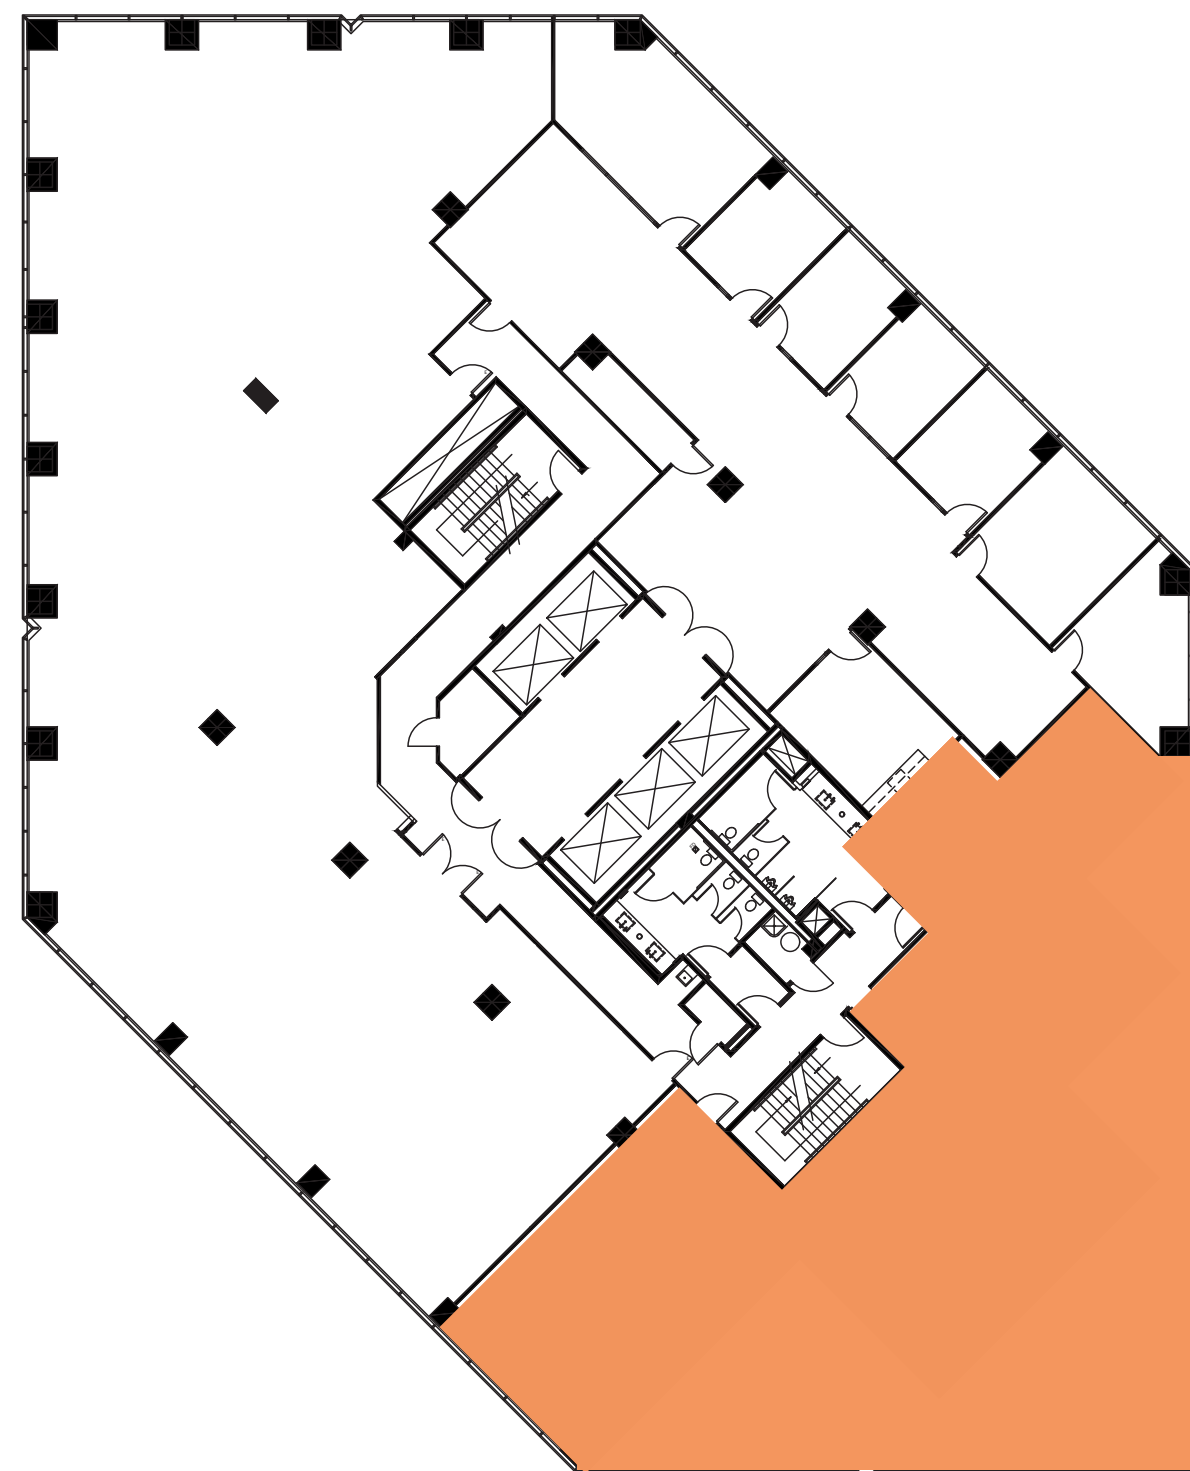

For leasing information please contact:

Jason Ward  
949.955.7640 | jason.ward@cushwake.com

John Harty  
949.372.4910 | john.harty@cushwake.com

Adie Jessup  
949.930.9258 | adie.jessup@cushwake.com