
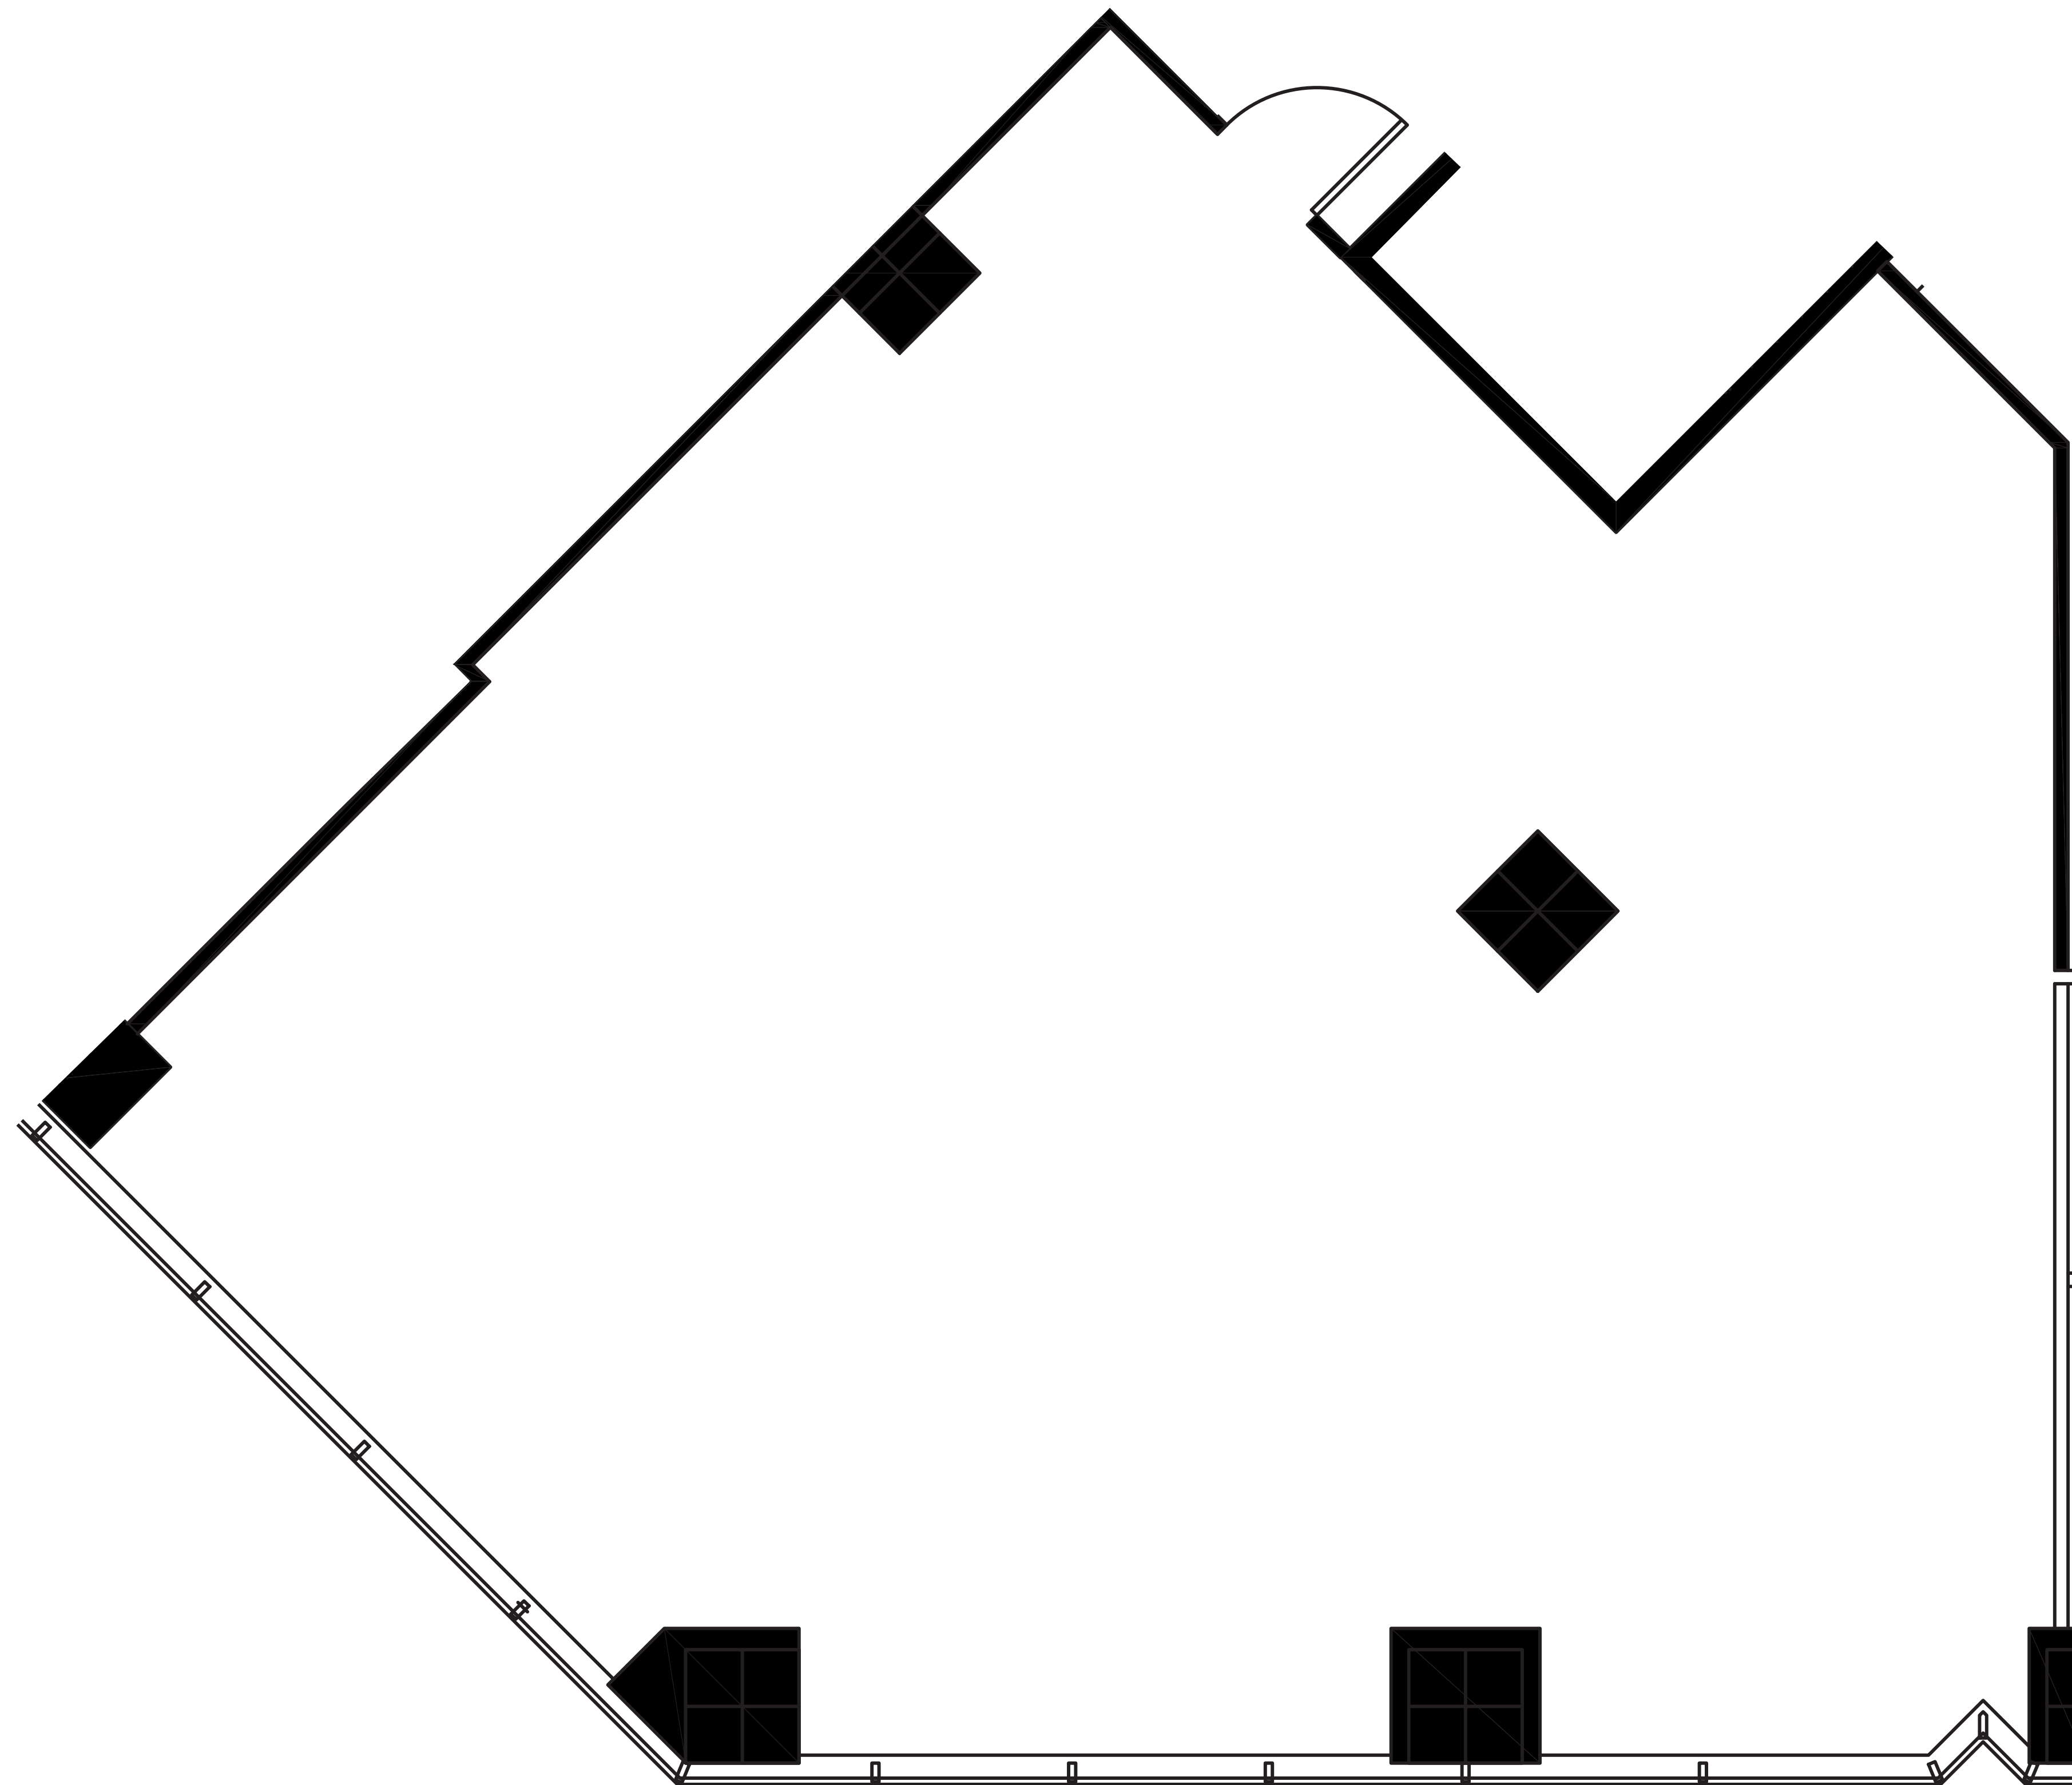


AS-BUILT CONFIGURATION

| | |
|-----------------------|-----|
| OFFICES..... | TBD |
| RECEPTION..... | TBD |
| CONFERENCE ROOMS..... | TBD |
| KITCHEN..... | TBD |
| OPEN WORK AREA..... | TBD |

Not to scale, furniture and appliances not included

KEY PLAN

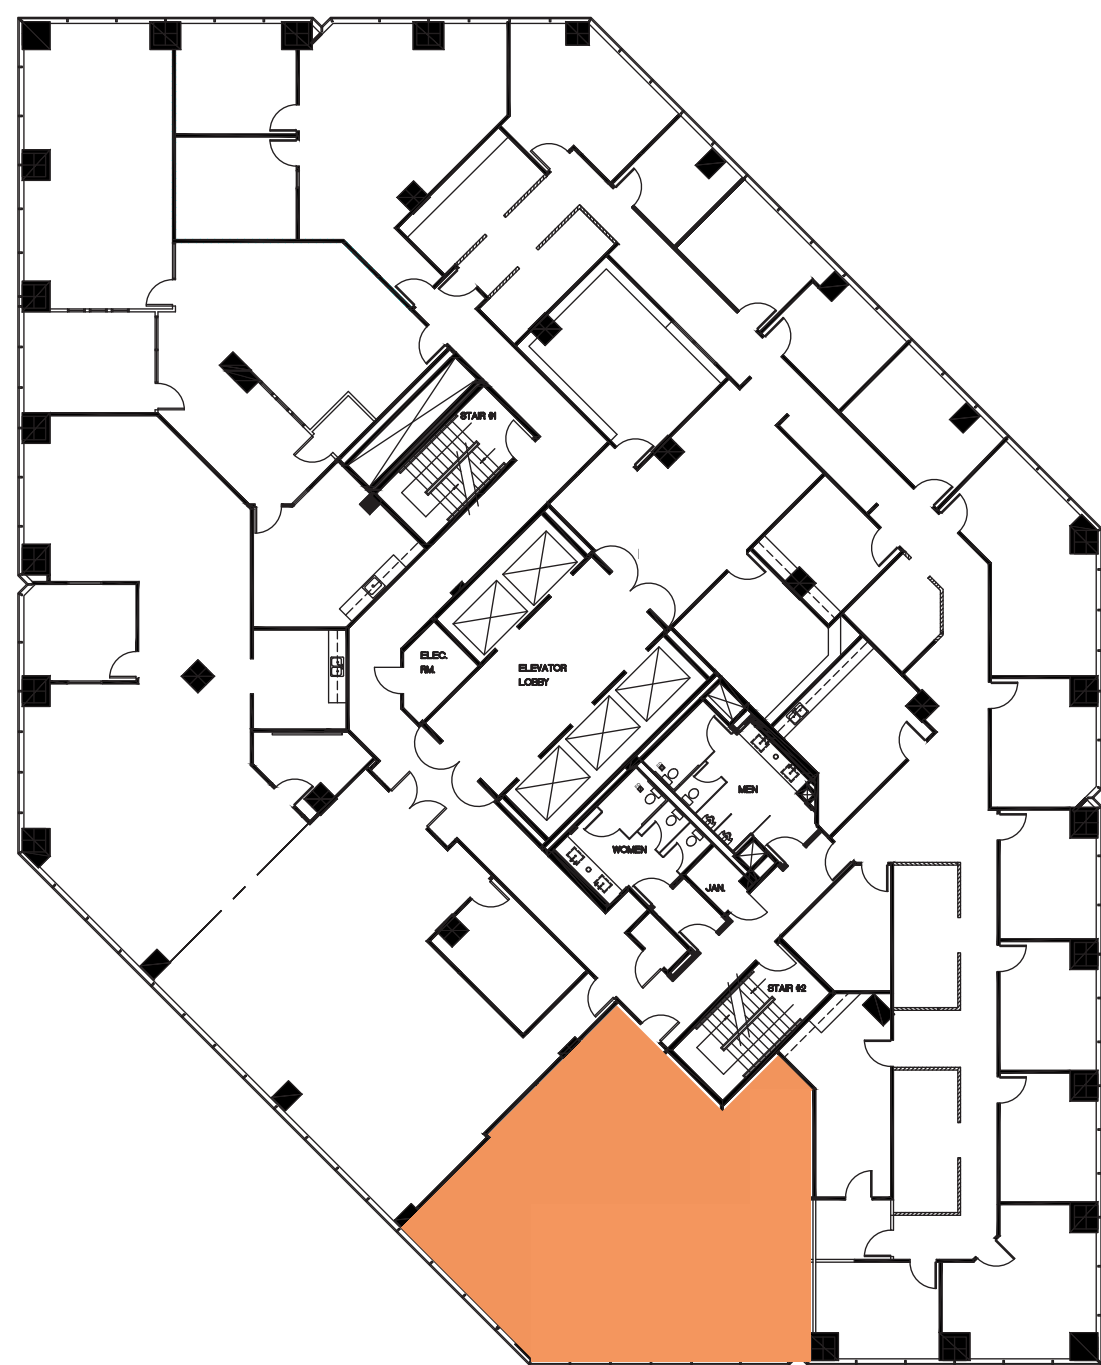

For leasing information please contact:

Jason Ward
949.955.7640 | jason.ward@cushwake.com

John Harty
949.372.4910 | john.harty@cushwake.com

Adie Jessup
949.930.9258 | adie.jessup@cushwake.com