



AS-BUILT CONFIGURATION

PRIVATE OFFICES1	
CONFERENCE ROOM1	
KITCHEN1	
OPEN WORK AREA+/-5	

Not to scale, furniture and appliances not included

KEY PLAN

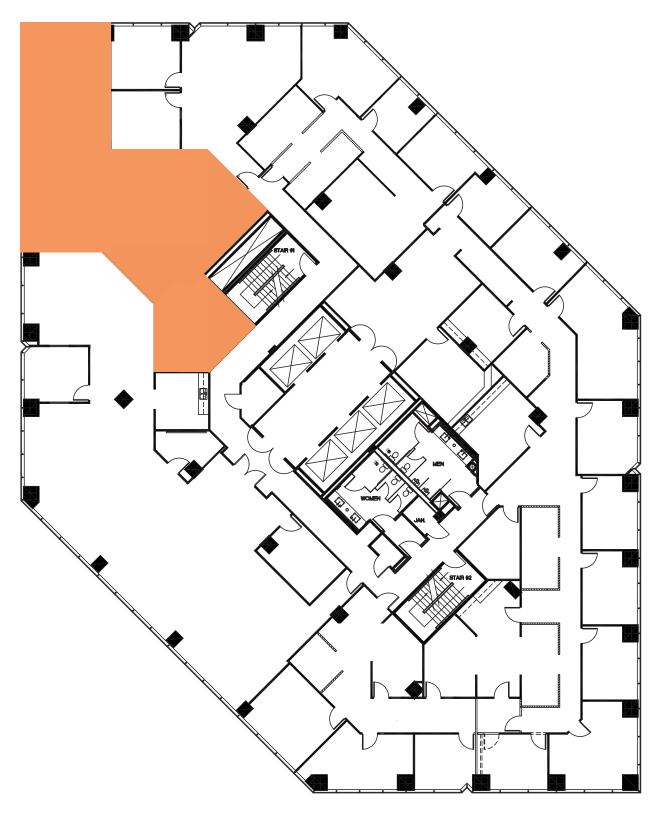

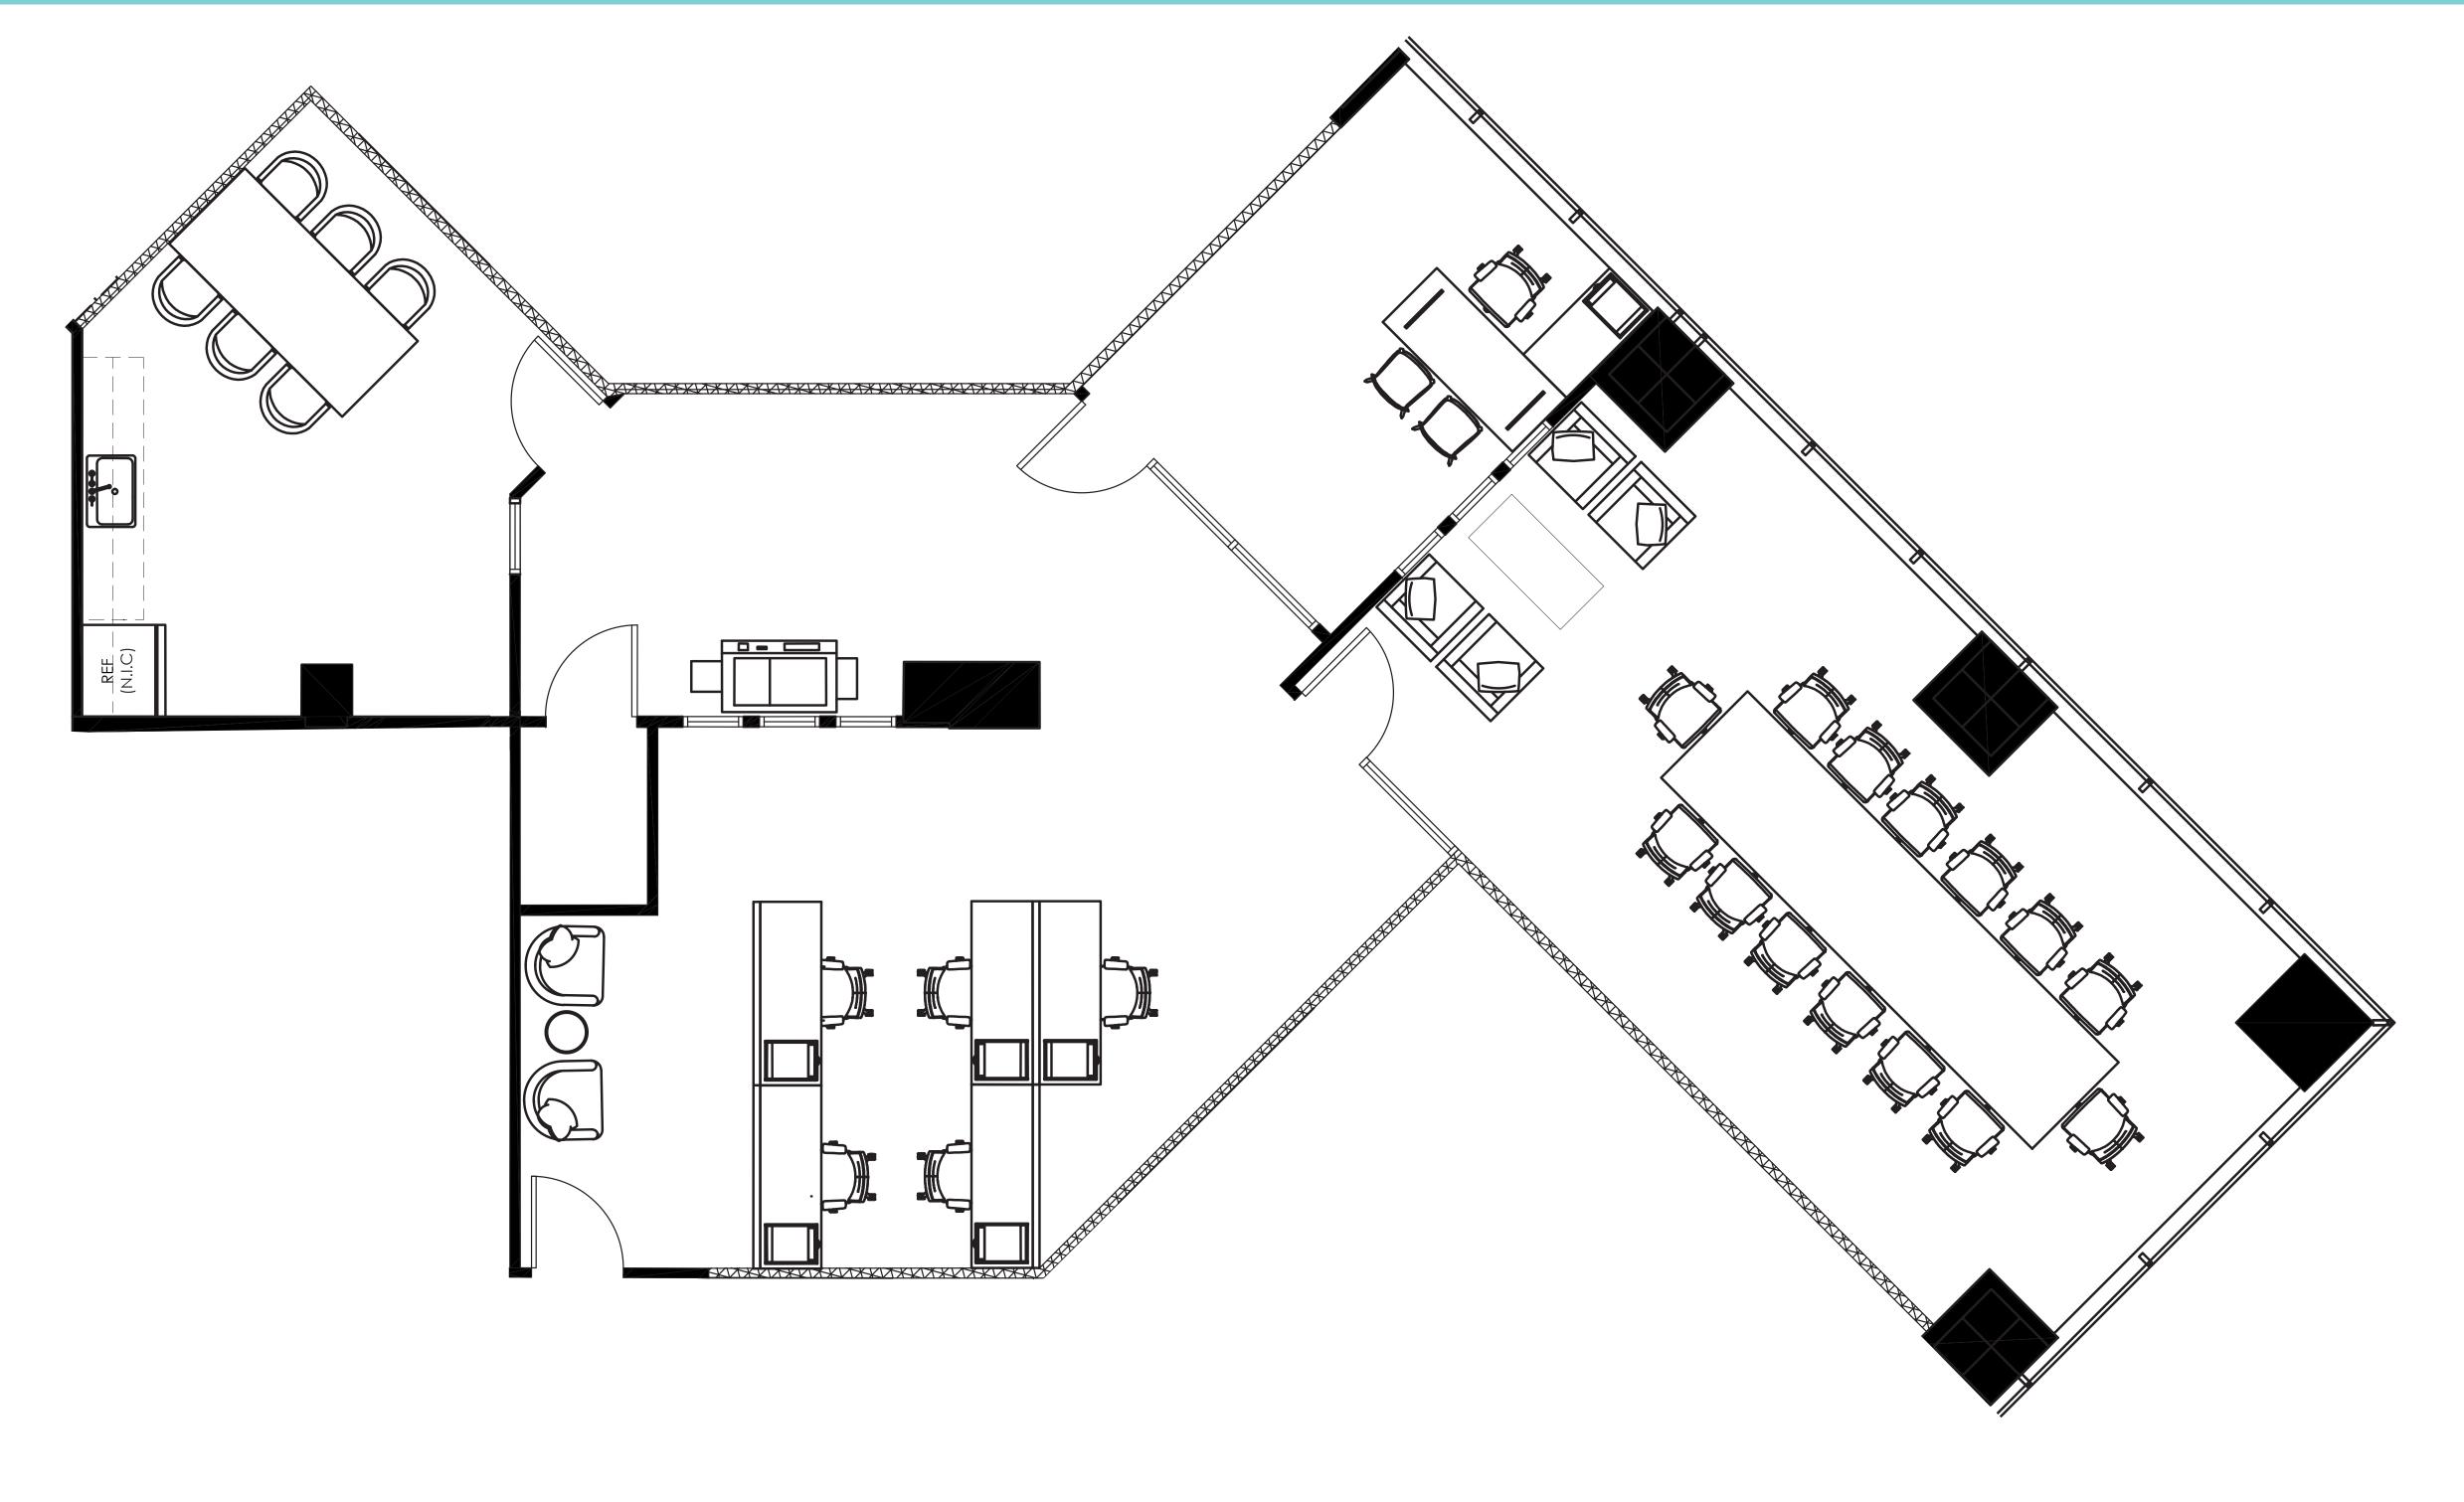

PLEASE CONTACT: USALEASING@ONNI.COM (213) 629 - 2041

RSF:2,059





