
SUITE: 510

AS-BUILT CONFIGURATION

OFFICES1	
CONFERENCE ROOMS1	
OPEN WORK AREA+/-18	3
KITCHEN1	

KEY PLAN Not to scale, furniture and appliances not included



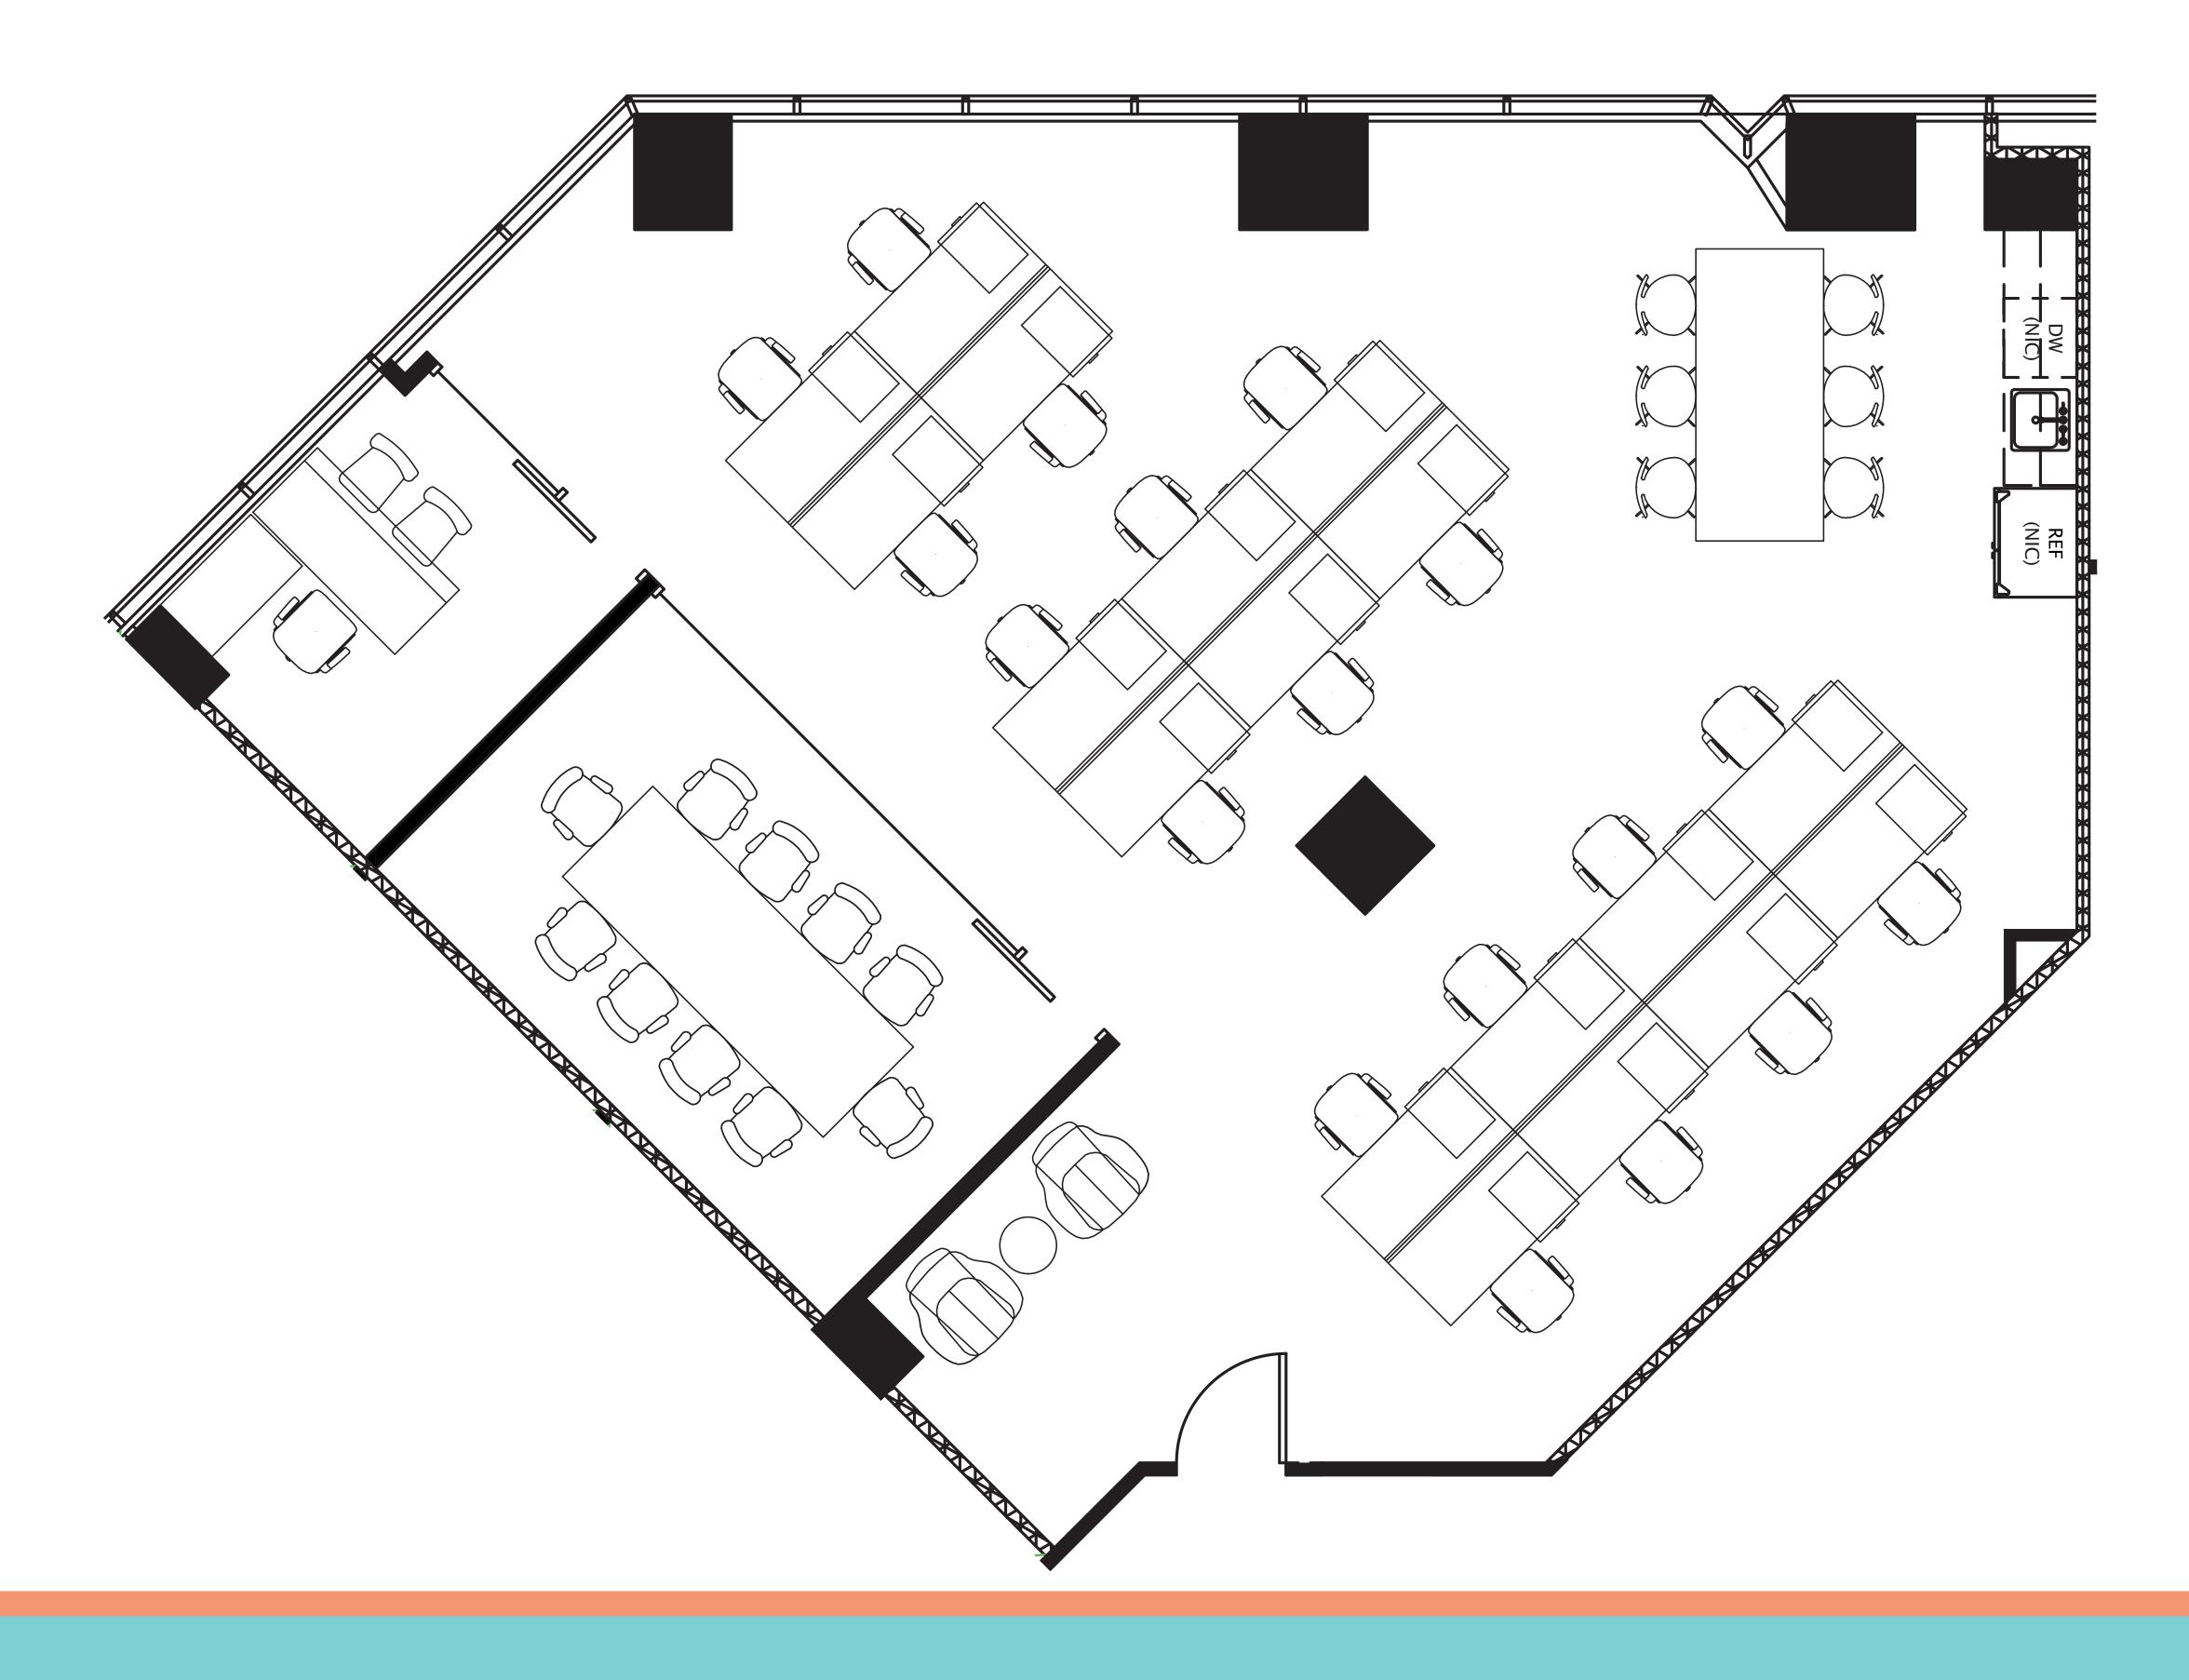

RSF: 1,820



