
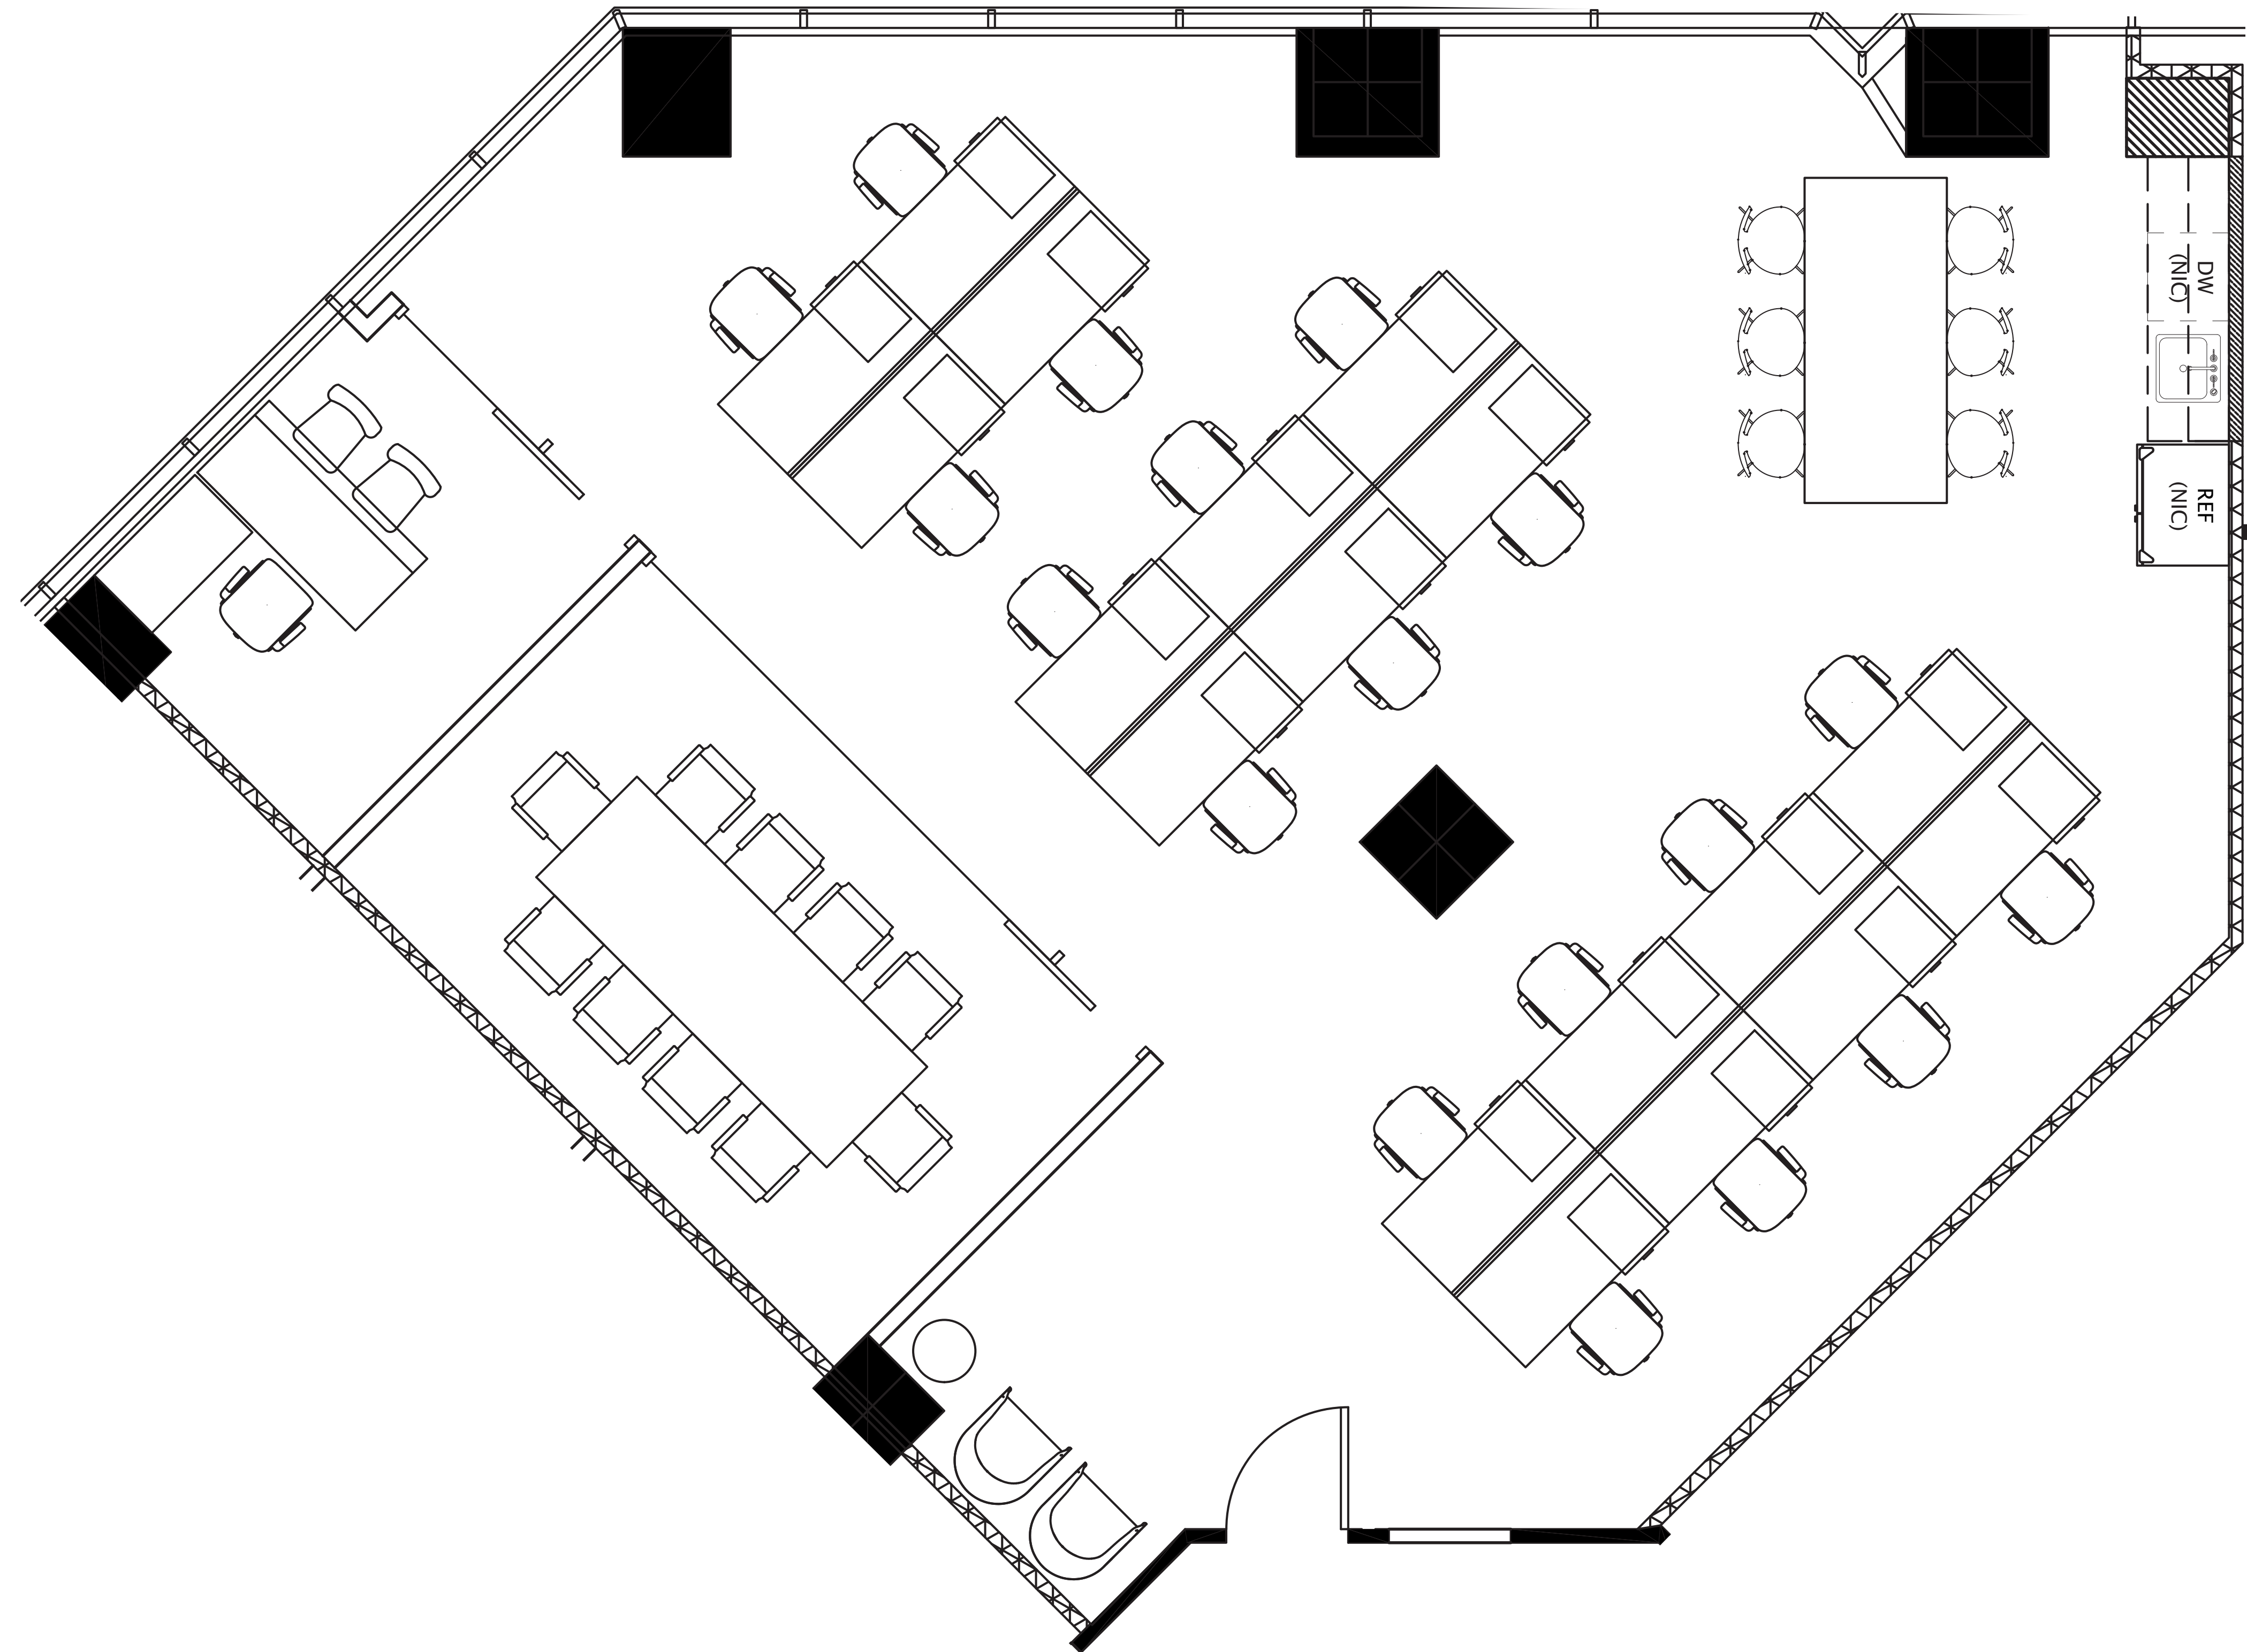


AS-BUILT CONFIGURATION

OFFICES.....	1
RECEPTION.....	1
CONFERENCE ROOMS.....	1
KITCHEN.....	1
OPEN WORK AREA.....	+/-18

Not to scale, furniture and appliances not included

KEY PLAN

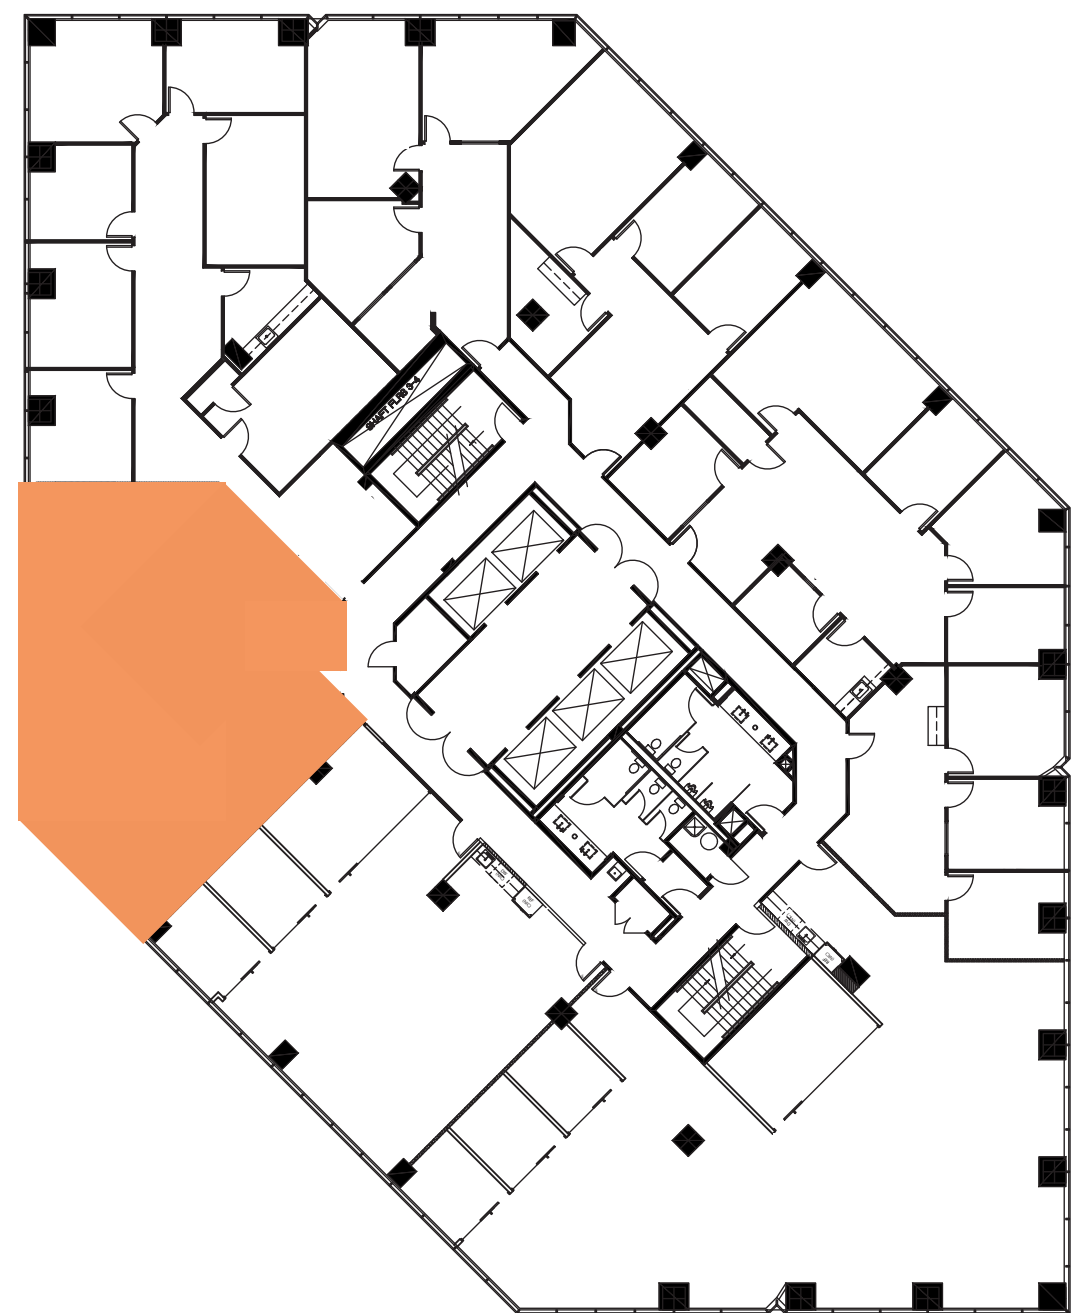

For leasing information please contact:

Jason Ward
949.955.7640 | jason.ward@cushwake.com

John Harty
949.372.4910 | john.harty@cushwake.com

Adie Jessup
949.930.9258 | adie.jessup@cushwake.com